






D/S 849 B

RECORDS DEPT.  
LONDON

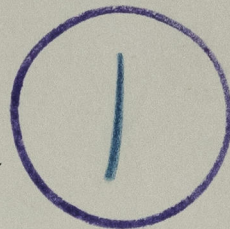

★ Engine Cliner & Engine Reck

Hull First Entry Report no.

52671

&

52748

Messrs Richard Dunster Ltd.  
Yard no. 461/3

Messrs Chas. D. Holmes Eng nos.  
1688 & 1708

+ Abaille 24

General Arrangement

Part I




© 2021

Lloyd's Register  
Foundation

013471-013480-0112



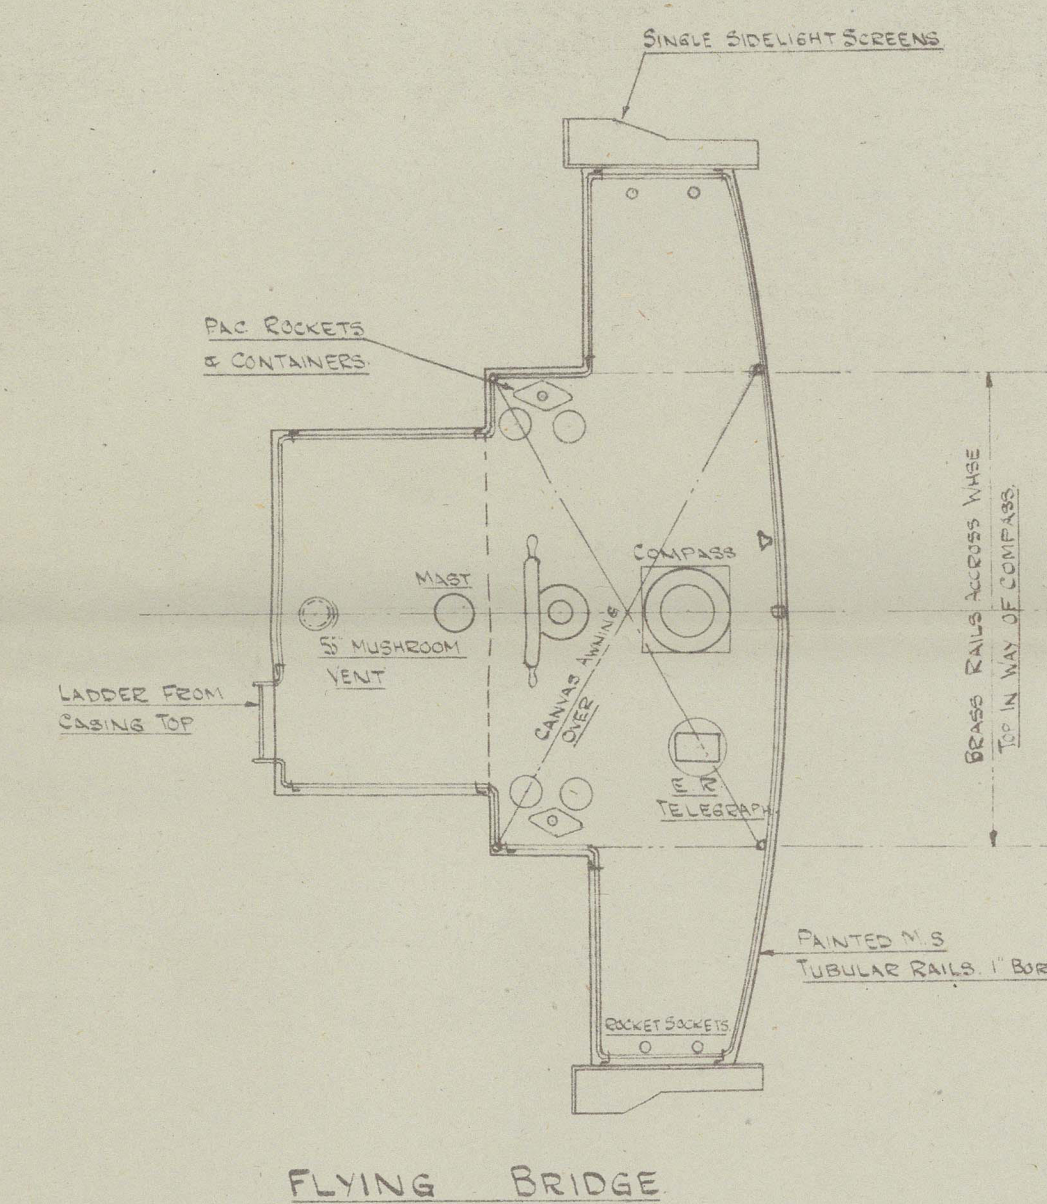

"EMPIRE ELINOR & EMPIRE BECKY"  
FOR FOREIGN SERVICE

RICHARD DUNSTON LTD.  
SHIPBUILDERS,  
THORNE, YORKSHIRE

DRAWN BY <i>W</i>		DATE <i>26.7.45</i>
TRACED BY		DATE
CHECKED BY		DATE <i>28.7.45</i>
REVISIONS		
No.	DATE	PARTICULARS

This Drawing and the Information it contains are the Property of RICHARD DUNSTON LTD  
It is not to be Traced, Copied or Published without their Written Consent, nor is the Information  
thereon to be misused in any way.

YARD No.	S 461 & 3	DRG. No.	4707
----------	-----------	----------	------

TITLE: GENERAL ARRANGEMENT - PART 1 - "AS BUILT"

SCALE:-  $\frac{1}{4}$ " TO ONE FOOT



D18 849 B

RECORDS DEPT.  
LONDON

2

★ Empire Elmer & Empire Becky  
Hull First Entry Report Nos.

52671

& 52748

Messrs. Richard Dunston Ltd.

Yard nos 461 & 463.

Messrs. Chas. D. Holmes & Co.

Eng's Nos. 1688 & 1708

General arrangement

Part 2.

X Abelle 24





© 2021

Lloyd's Register  
Foundation

013471-013480-0113



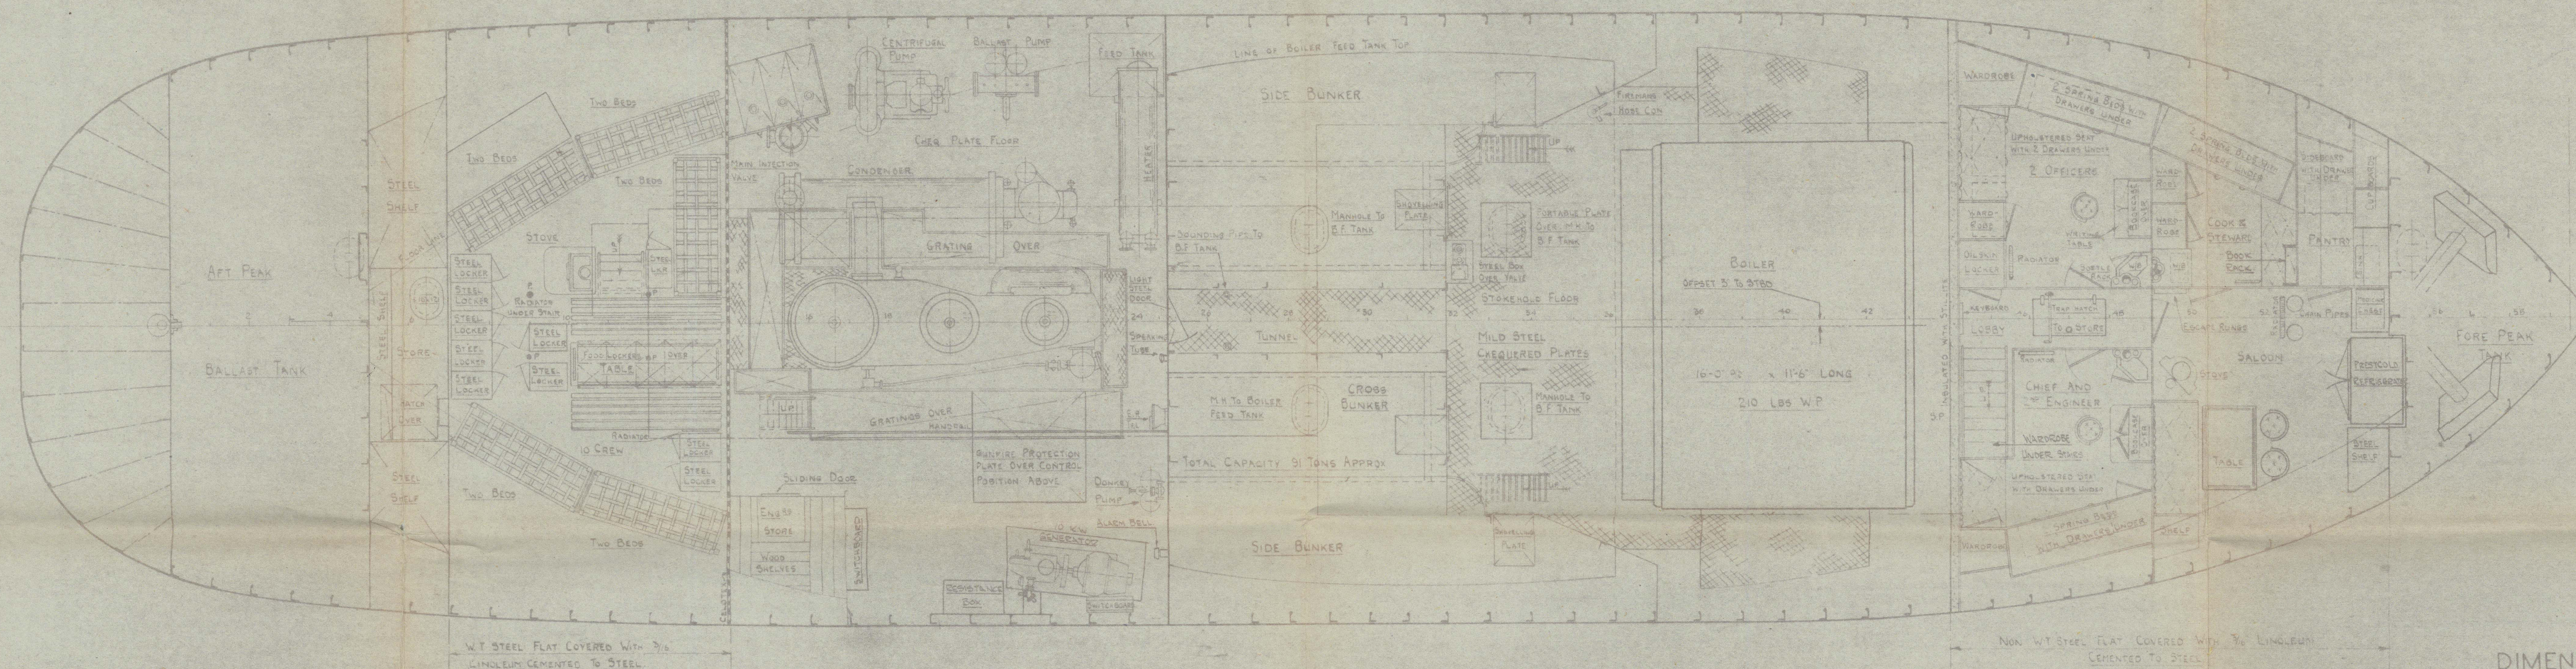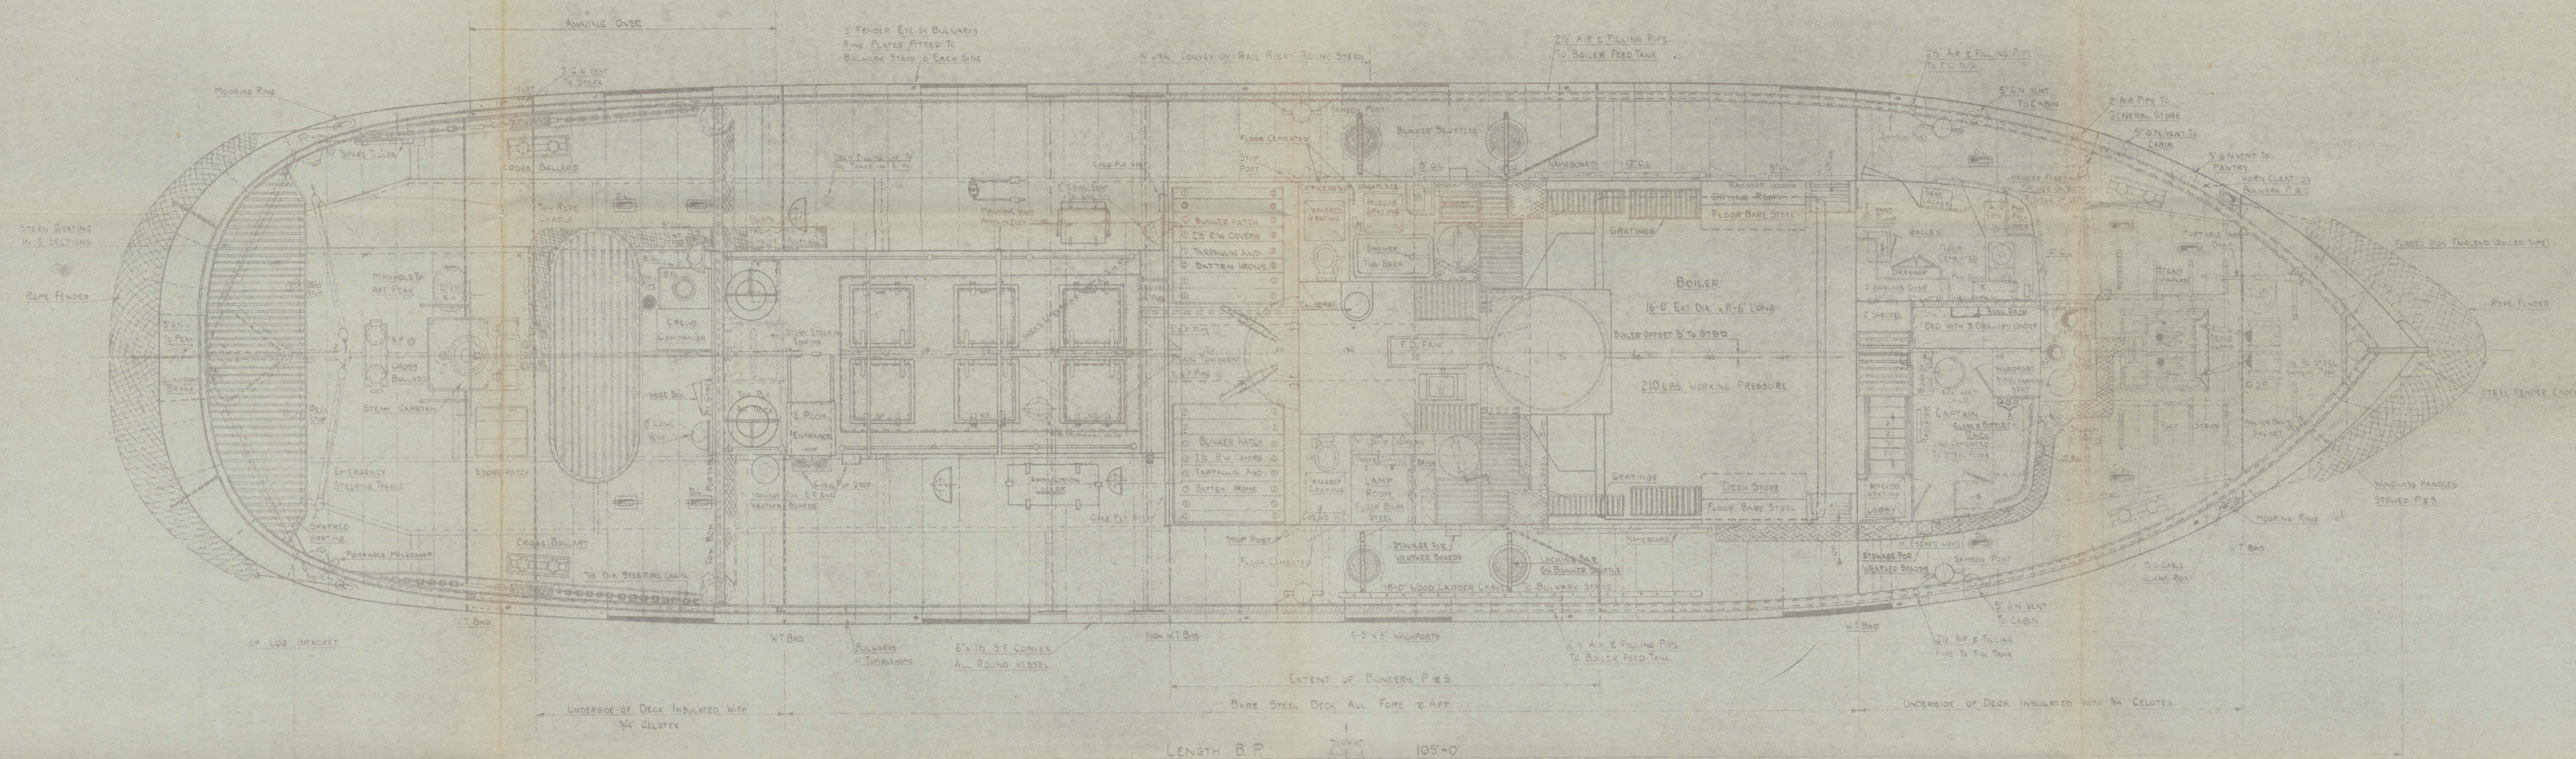

# **SINGLE SCREW STEAM TUG**

**"EMPIRE ELINOR" & "EMPIRE BECKY"**

DIMENSIONS:-  
 LENGTH B.P. 105'-0"  
 BREADTH MLD. 26'-6"  
 DEPTH MLD. 13'-6"  
 To Top of Flat Plate Keel Amidships

**RICHARD DUNSTON LTD.**  
 SHIPBUILDERS.  
 THORNE, YORKSHIRE

DRAWN BY	DATE
TRACED BY	DATE
CHECKED BY	DATE
REVISIONS	
No.	DATE PARTICULARS

This Drawing and the information it contains are the Property of RICHARD DUNSTON LTD. It is not to be Traced, Copied or Published without their Written Consent, nor is the information thereon to be misused in any way.

**YARD No. S.461 & 3** **DRG. No. 4707**

**TITLE:- GENERAL ARRANGEMENT PART 2 "AS BUILT"**

**SCALE:- 1/4" TO ONE FOOT**